


Legend

- ✕ As Laid Wave Rider Buoy
- ▨ SSSI
- ▨ SNH Marine Protection Area
- ▨ Special Area of Conservation
- ▭ Beatrice Offshore Wind Farm Site

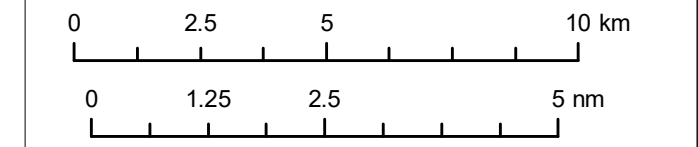

Data Source:
 SNH, 2017. © British Crown and SeaZone Solutions Limited. All rights reserved. Products licence No. 112009.005.

Drawing Title

As Laid Wave Rider Buoy Locations

Ver	Date	Remarks	Drawn	Checked
01	21/07/2017	First issue	MM	LR
02	26/07/2017	Scale change	CS	LR

Drawing Number

BEA-MAP-SSER-735

Scale	Plot Size	Datum	Projection
1:150,000	A3	WGS84	UTM30N

SSE Renewables (UK) Ltd. 2017. The concepts and information contained in this document are the copyright of SSE Renewables (UK) Ltd. Use or copying of the document in whole or in part without the written permission of SSE Renewables (UK) Ltd constitutes an infringement of copyright. SSE Renewables (UK) Ltd. does not warrant that this document is definitive nor free of error and does not accept liability for any loss caused or arising from reliance upon information provided herein.

