



ELEVATION ON 'A-A' @ HIGH WATER

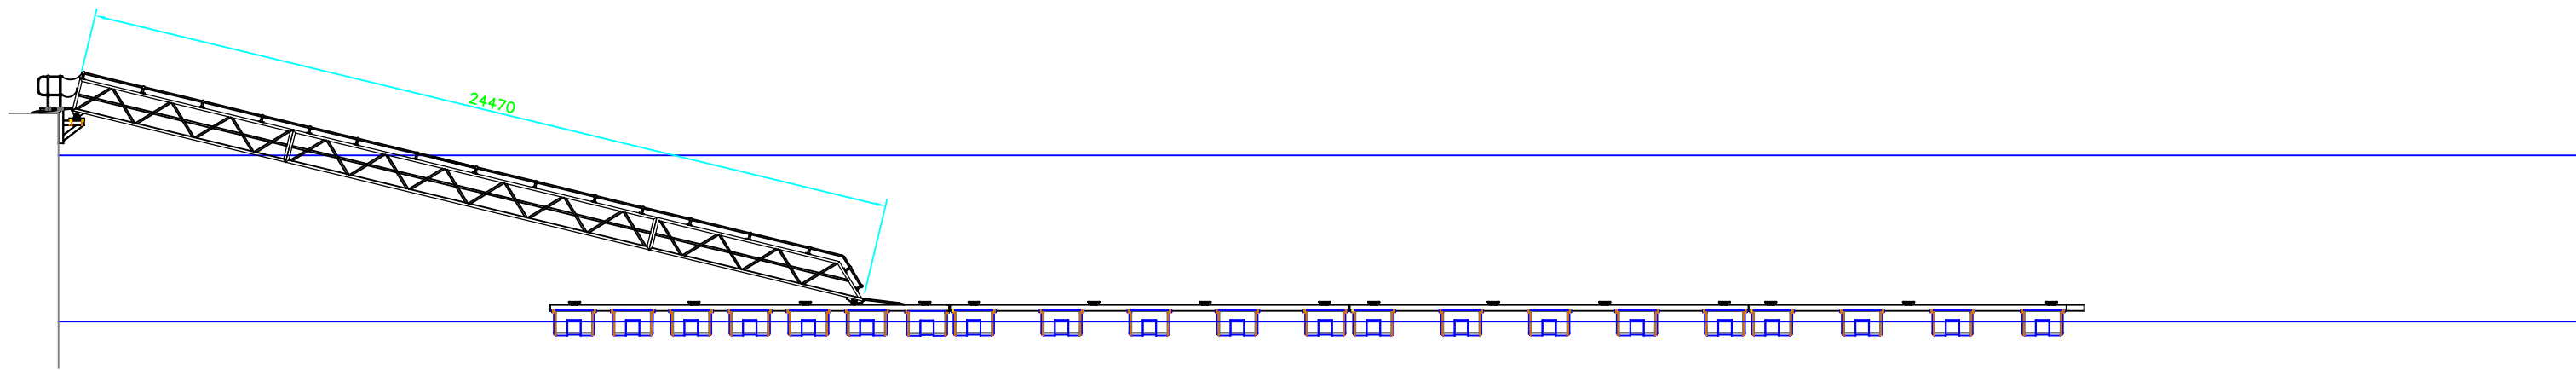

ELEVATION ON 'A-A' @ LOW WATER

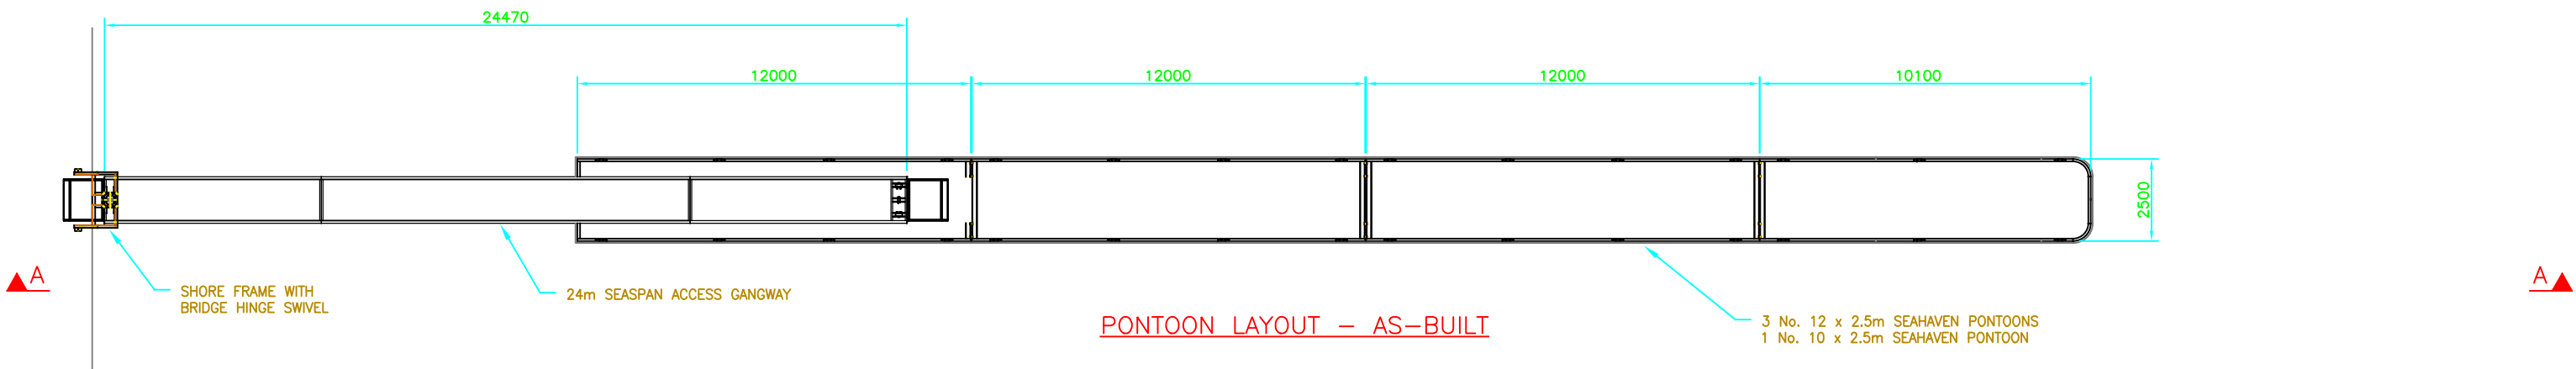

PONTOON LAYOUT - AS-BUILT

3 No. 12 x 2.5m SEAHAVEN PONTOONS
1 No. 10 x 2.5m SEAHAVEN PONTOON

REV.	DATE	DESCRIPTION	BY	CHK'D	DATE
A1	22.06.21	FIRST ISSUE	K.W.	S.M.	22.06.21
Z1	31.10.22	AS-BUILT	K.W.	S.O.	31.10.22

PAINT / FINISH SPECIFICATION
-

GENERAL NOTES (Unless Noted Otherwise)

- ALL DIMENSIONS IN MILLIMETRES (mm)
- IF IN DOUBT ASK

GaelForce
ENGINEERING

136 ANDERSON STREET,
INVERNESS, IV3 8DH
T. 01463 229400

www.gaelforcegroup.com

DRAWING TITLE: CUDDY POINT PONTOON ELEVATION - AS-BUILT		CLIENT: -
CONTRACT DESCRIPTION: PONTOONS		CONTRACT DWG. No: E-5795-004
DRAWN BY: K. WATSON	DATE: 22.06.2021	STANDARD DWG. REF: -
CHECKED: S. MILNE	DATE: 22.06.2021	REVISION: -
SCALE: N.T.S.		