



TYP. DISCHARGE EMBEDMENT SECTION THROUGH CENTRE LINE OF PIPE Scale 1/20

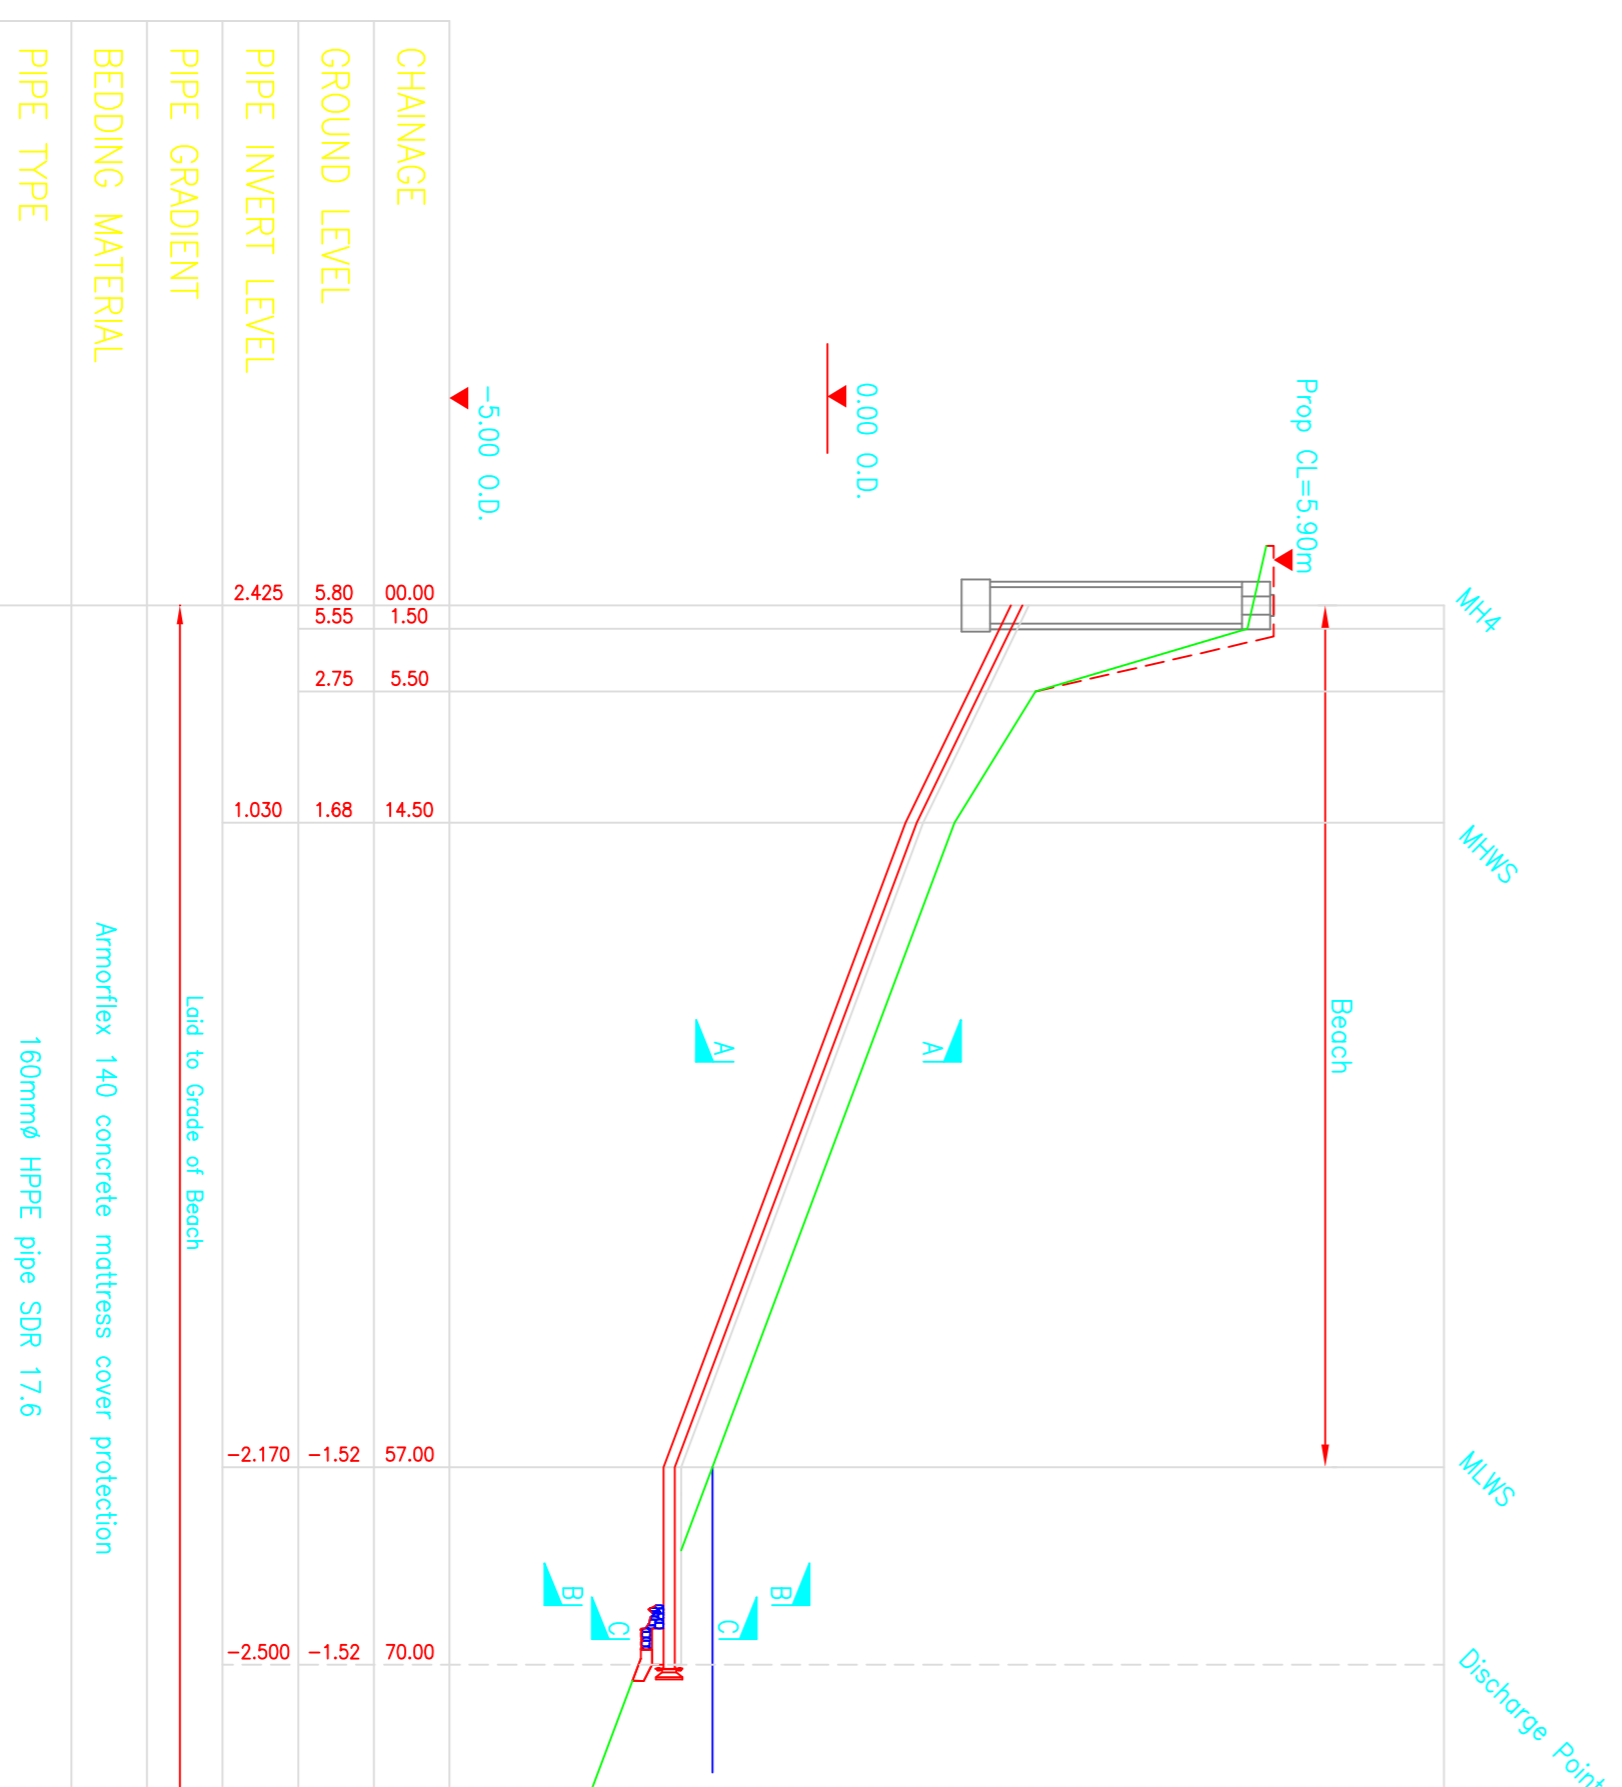


- Notes**
- All dimensions are in millimetres unless shown otherwise. Do not scale.
 - All levels are reduced to Ordnance datum.
 - Armourflex by MMG Civil Engineering Systems Ltd. or equal approved.
 - Where natural ingress of fines is not possible or likely, Armourflex blocks 5-20mm between adjacent concrete filled socks should be brushed into spaces between them.
Armourflex 140 - 0.016m³/m²

Rev	Date	By	Description
R	15/05/06	DOB	AS-BUILT DRAWING

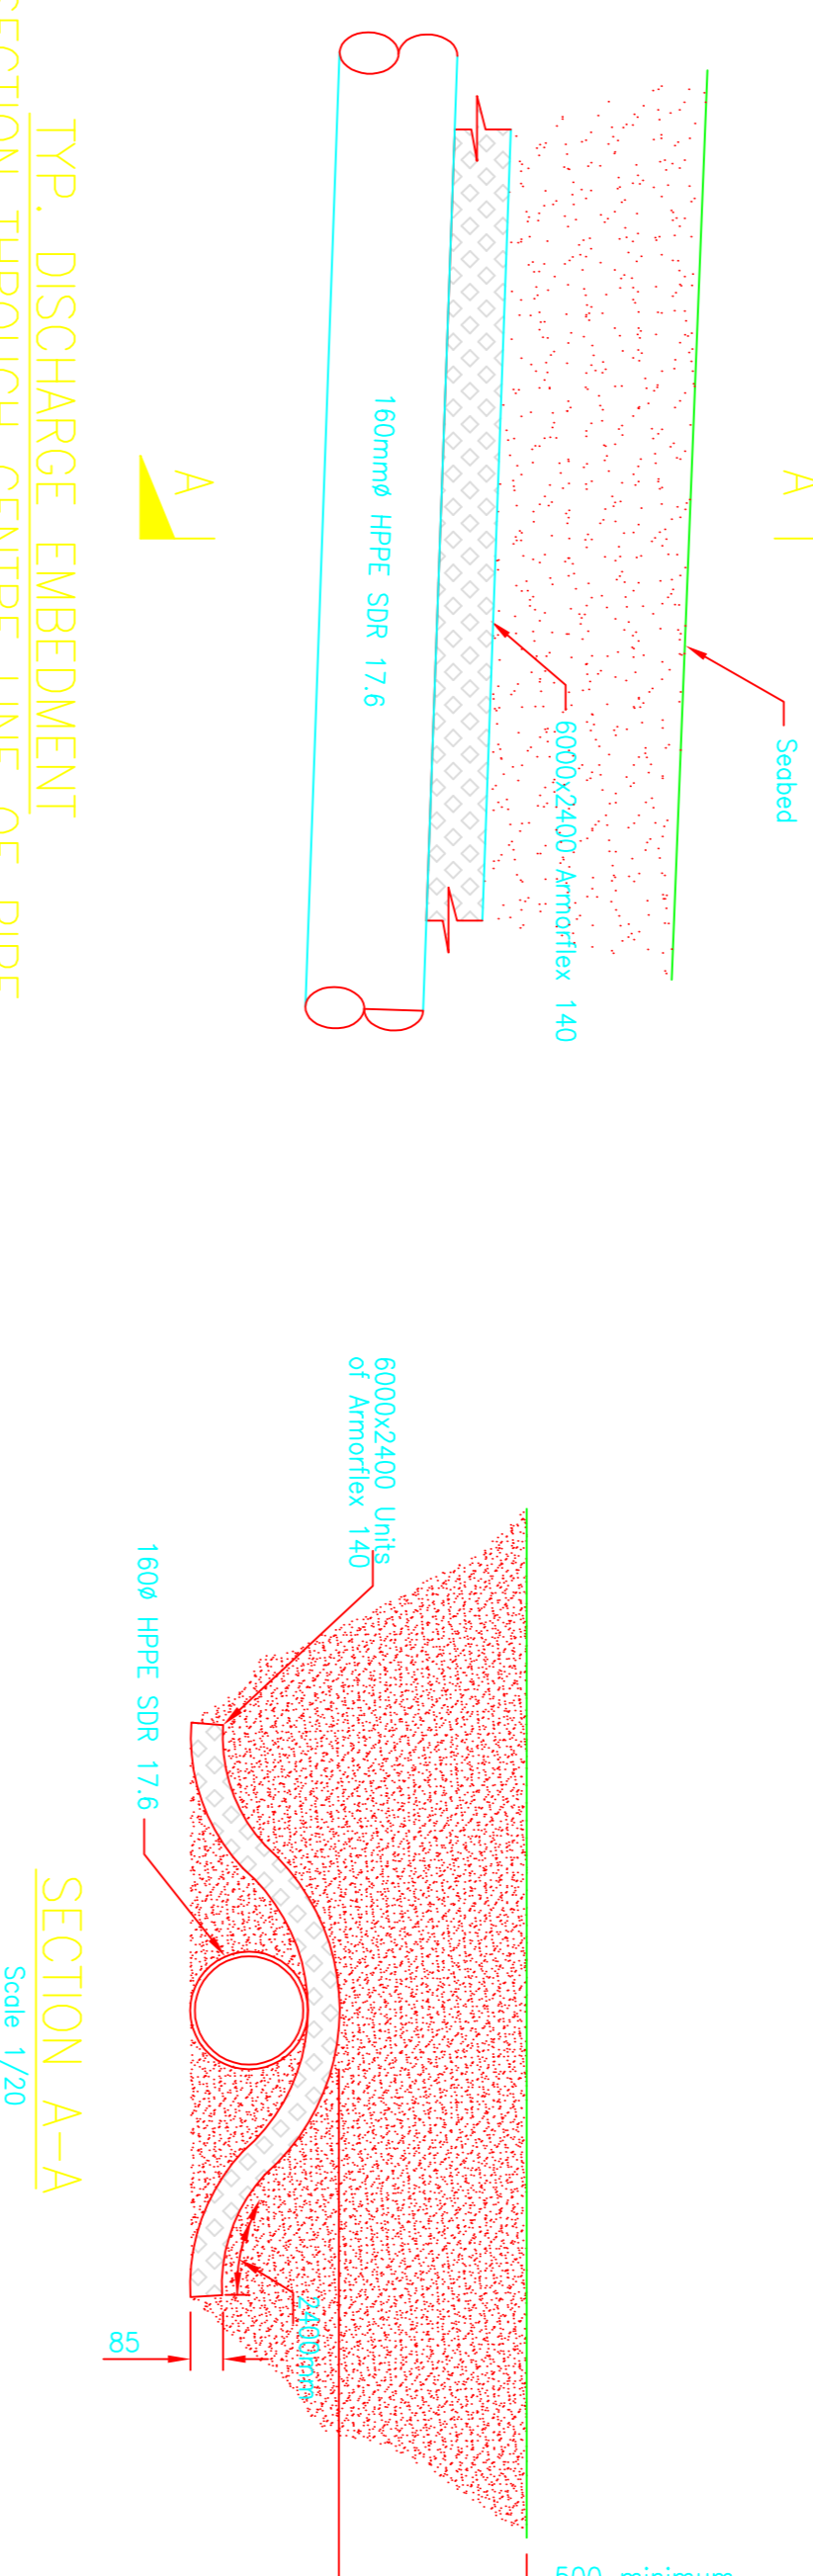

CHIEF EXECUTIVE: DR. JON HARGREAVES
Castle House, 6 Castle Drive, Carnegie Campus,
Dunfermline, Fife KY11 5DB

SW Project ID: 000752
SW Contract No.: C04027

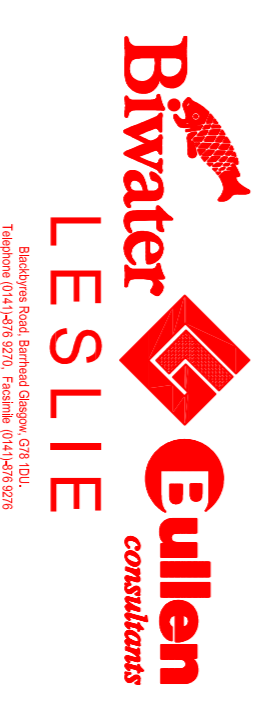

Drawing Originator: Bullen Consultants Ltd.
Strategic Reference Contract No.: 01011
Strategic Reference Draw No.: 7117

Project Title: DUNNOV SEMERAGE & WWT RATIONALSATION
Drawing Title: STRACHUR SEPTIC TANK AT HAZELDEAN OUTFALL PIPE DETAILS

Scale(s)	AS SHOWN	AT				
Drawn By	JT	22/07/05	Checked By	AGY	Approved By	ALS
Issued For	AS-BUILT	Revision				R