


# Marine Aquaculture Site **Seaforth**

## PLANNING APPLICATION

### Annex 1. Site Charts and Coordinates

**Mowi Scotland Limited**  
**June 2025**

|                                                                                                                                                                                |                                                                                          |                                                                                       |
|--------------------------------------------------------------------------------------------------------------------------------------------------------------------------------|------------------------------------------------------------------------------------------|---------------------------------------------------------------------------------------|
| Registered in Scotland No. 138843<br><b>Registered Office,</b><br><b>1st Floor, Admiralty Park</b><br><b>Admiralty Road</b><br><b>Rosyth</b><br><b>FIFE</b><br><b>KY11 2YW</b> | <small>OFFICE</small><br>Farms Office, Glen Nevis Business Park<br>PH33 6RX Fort William | <small>FAX</small><br>-                                                               |
|                                                                                                                                                                                | <small>POSTAL</small><br>Farms Office, Glen Nevis Business Park<br>PH33 6RX Fort William | <small>MAIL</small><br><a href="mailto:environment@mowi.com">environment@mowi.com</a> |
|                                                                                                                                                                                |                                                                                          | <small>WEB</small><br><a href="http://mowi.com">http://mowi.com</a>                   |

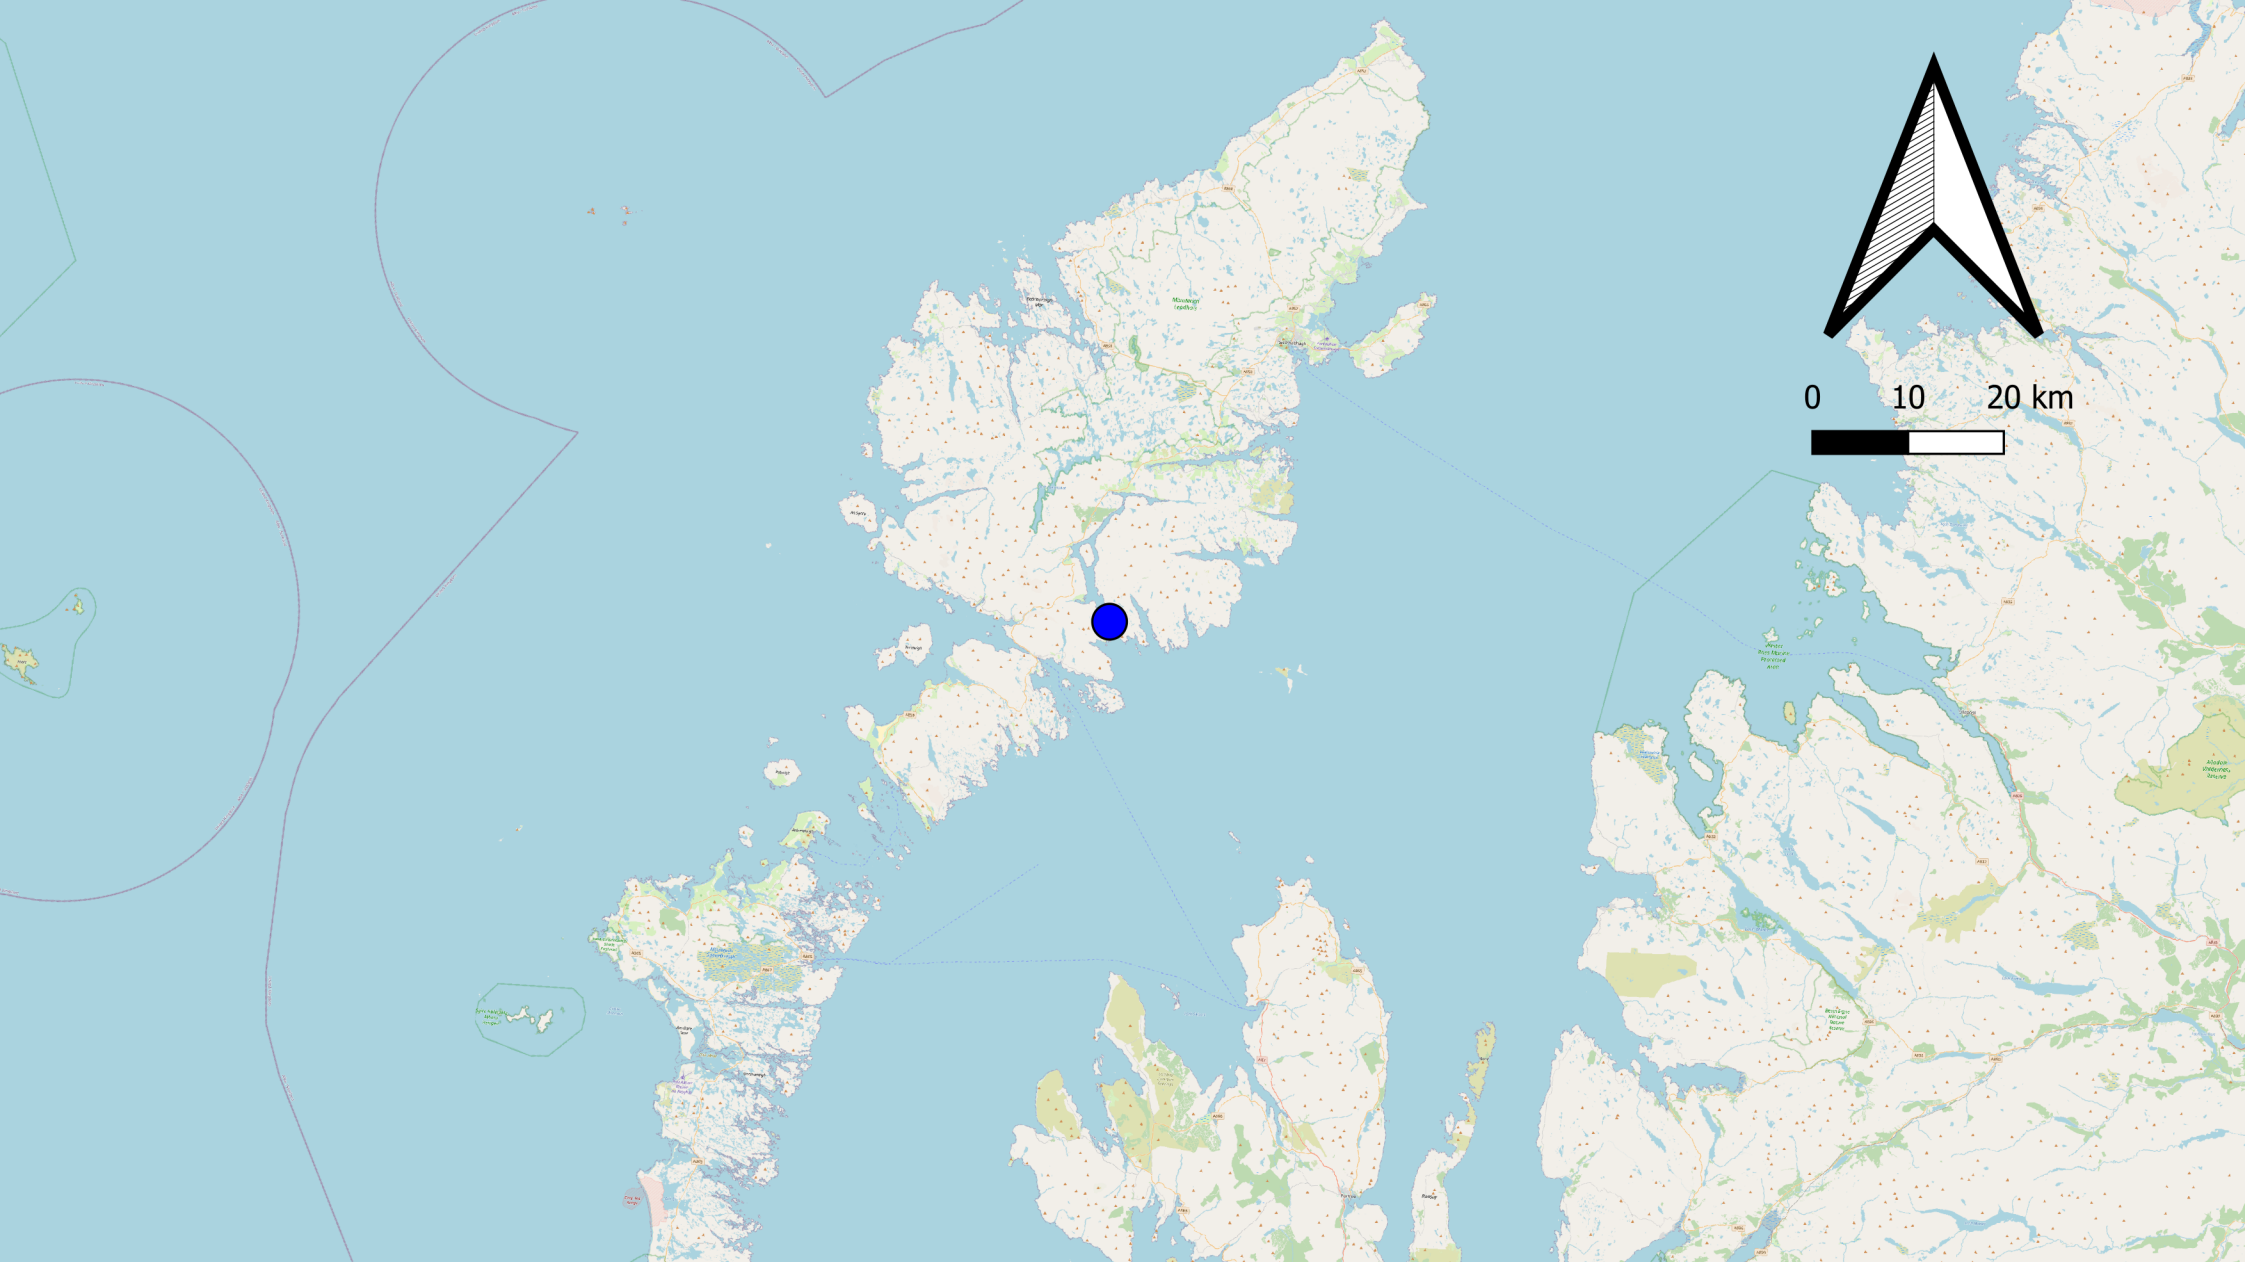

## SEAFOORTH AND NOSTER FISH FARMS

### Legend

- Location of Seaforth and Noster fish farms

1:600000

2025-05-23


SH

Map of site location


Scale

Date


Drawn

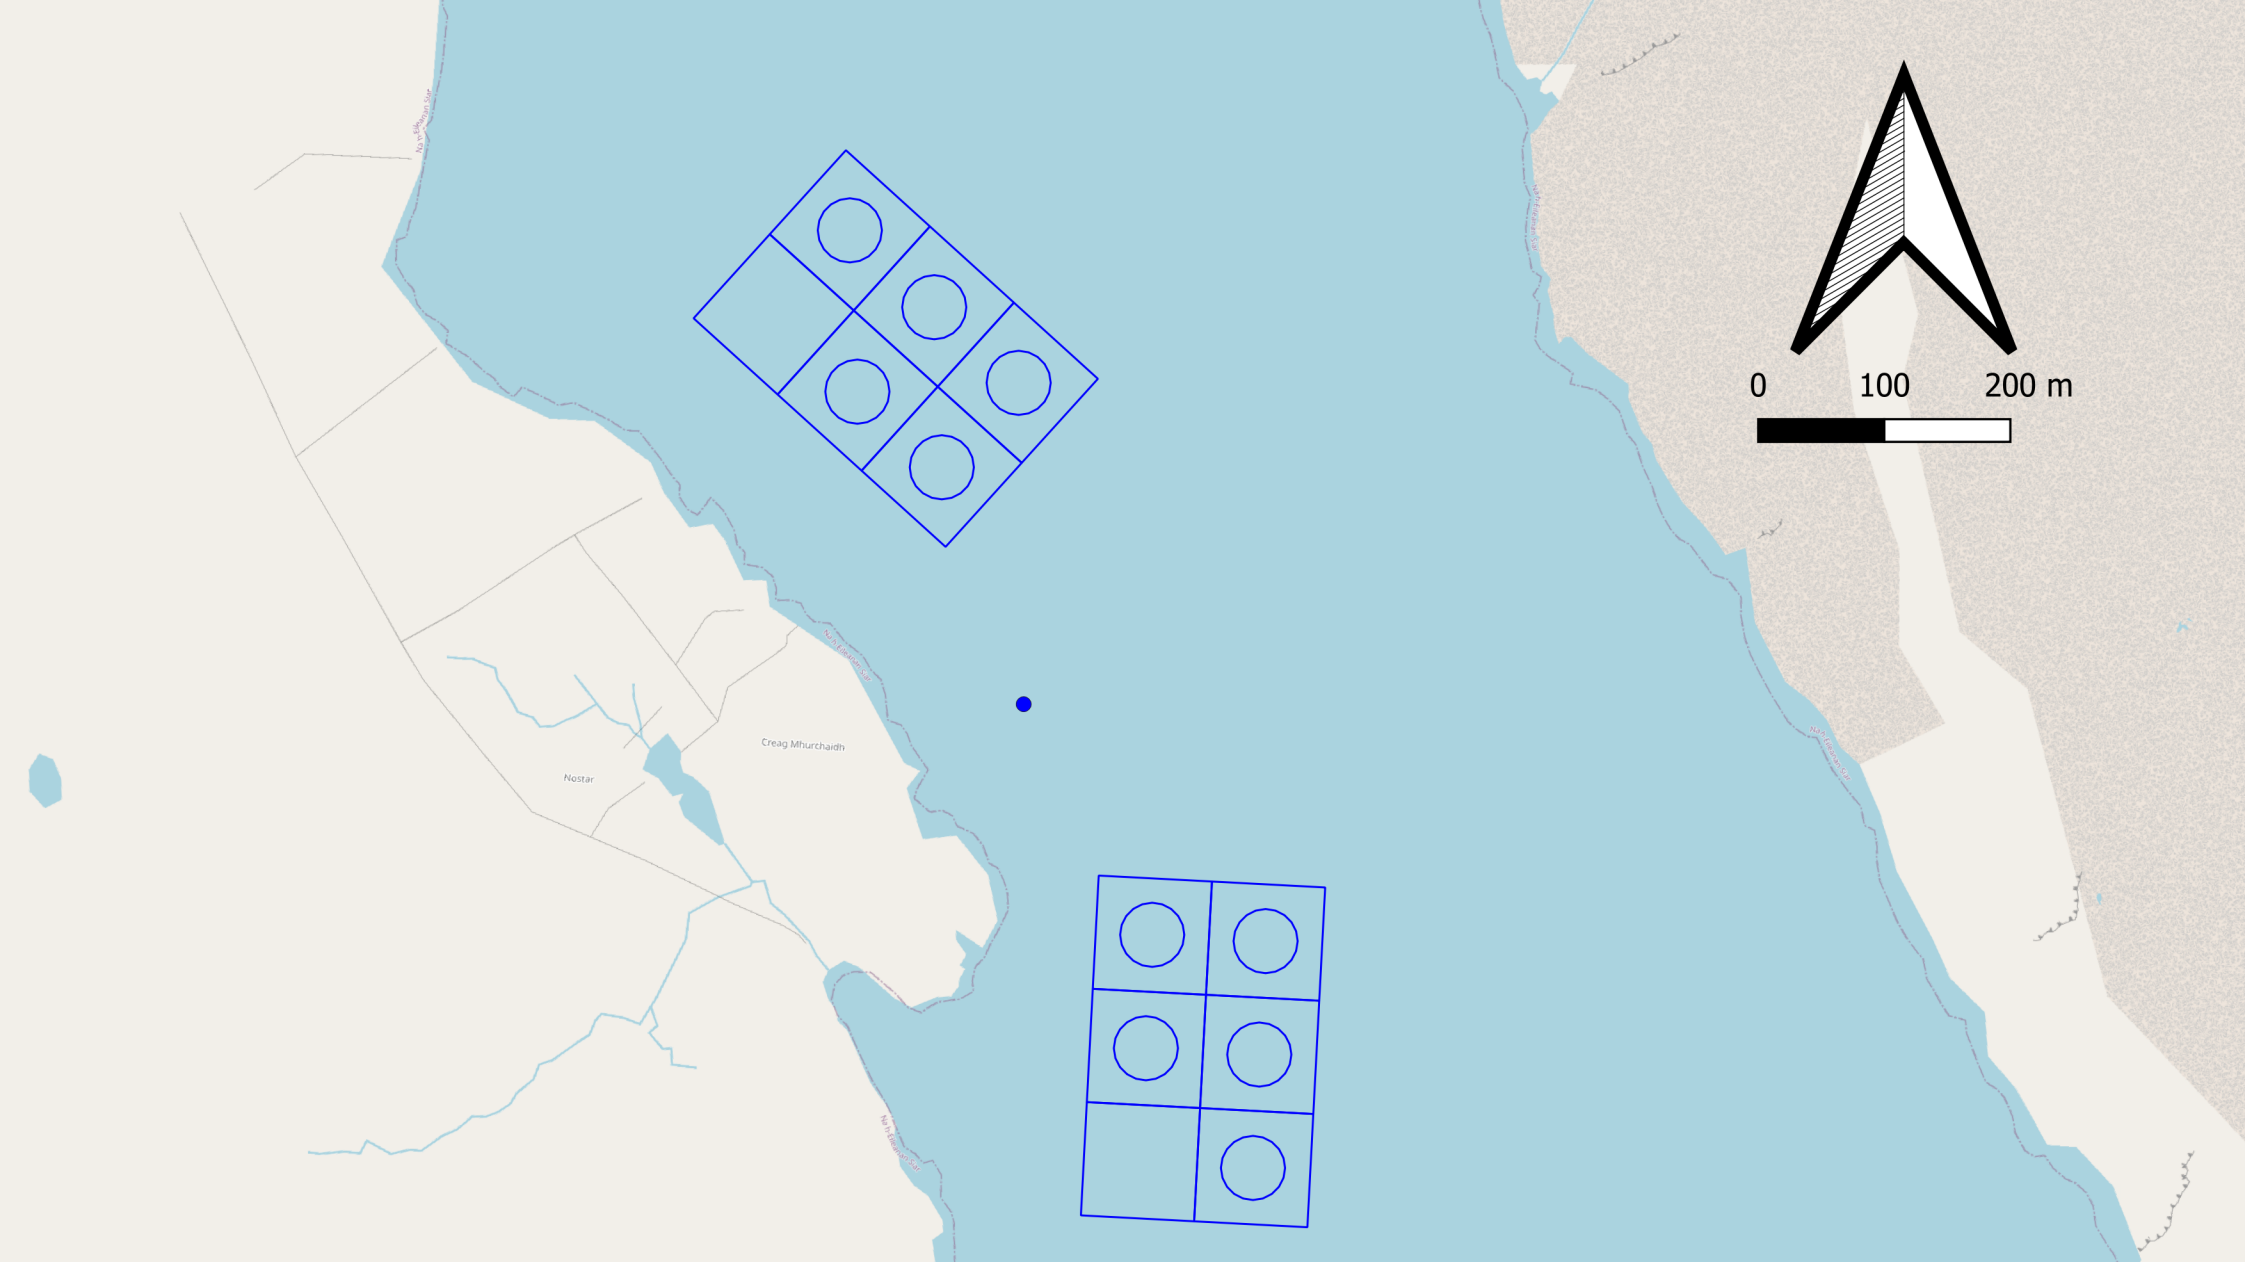

|                                |                                                                                                                              |        |            |       |
|--------------------------------|------------------------------------------------------------------------------------------------------------------------------|--------|------------|-------|
| SEAFORTH AND NOSTER FISH FARMS | <b>Legend</b><br><div><div></div> Existing 160m pens at Noster and Seaforth</div> <div><div></div> Existing Feed Barge</div> | 1:6000 | 2025-05-27 | SH    |
| Site Plan                      |                                                                                                                              | Scale  | Date       | Drawn |

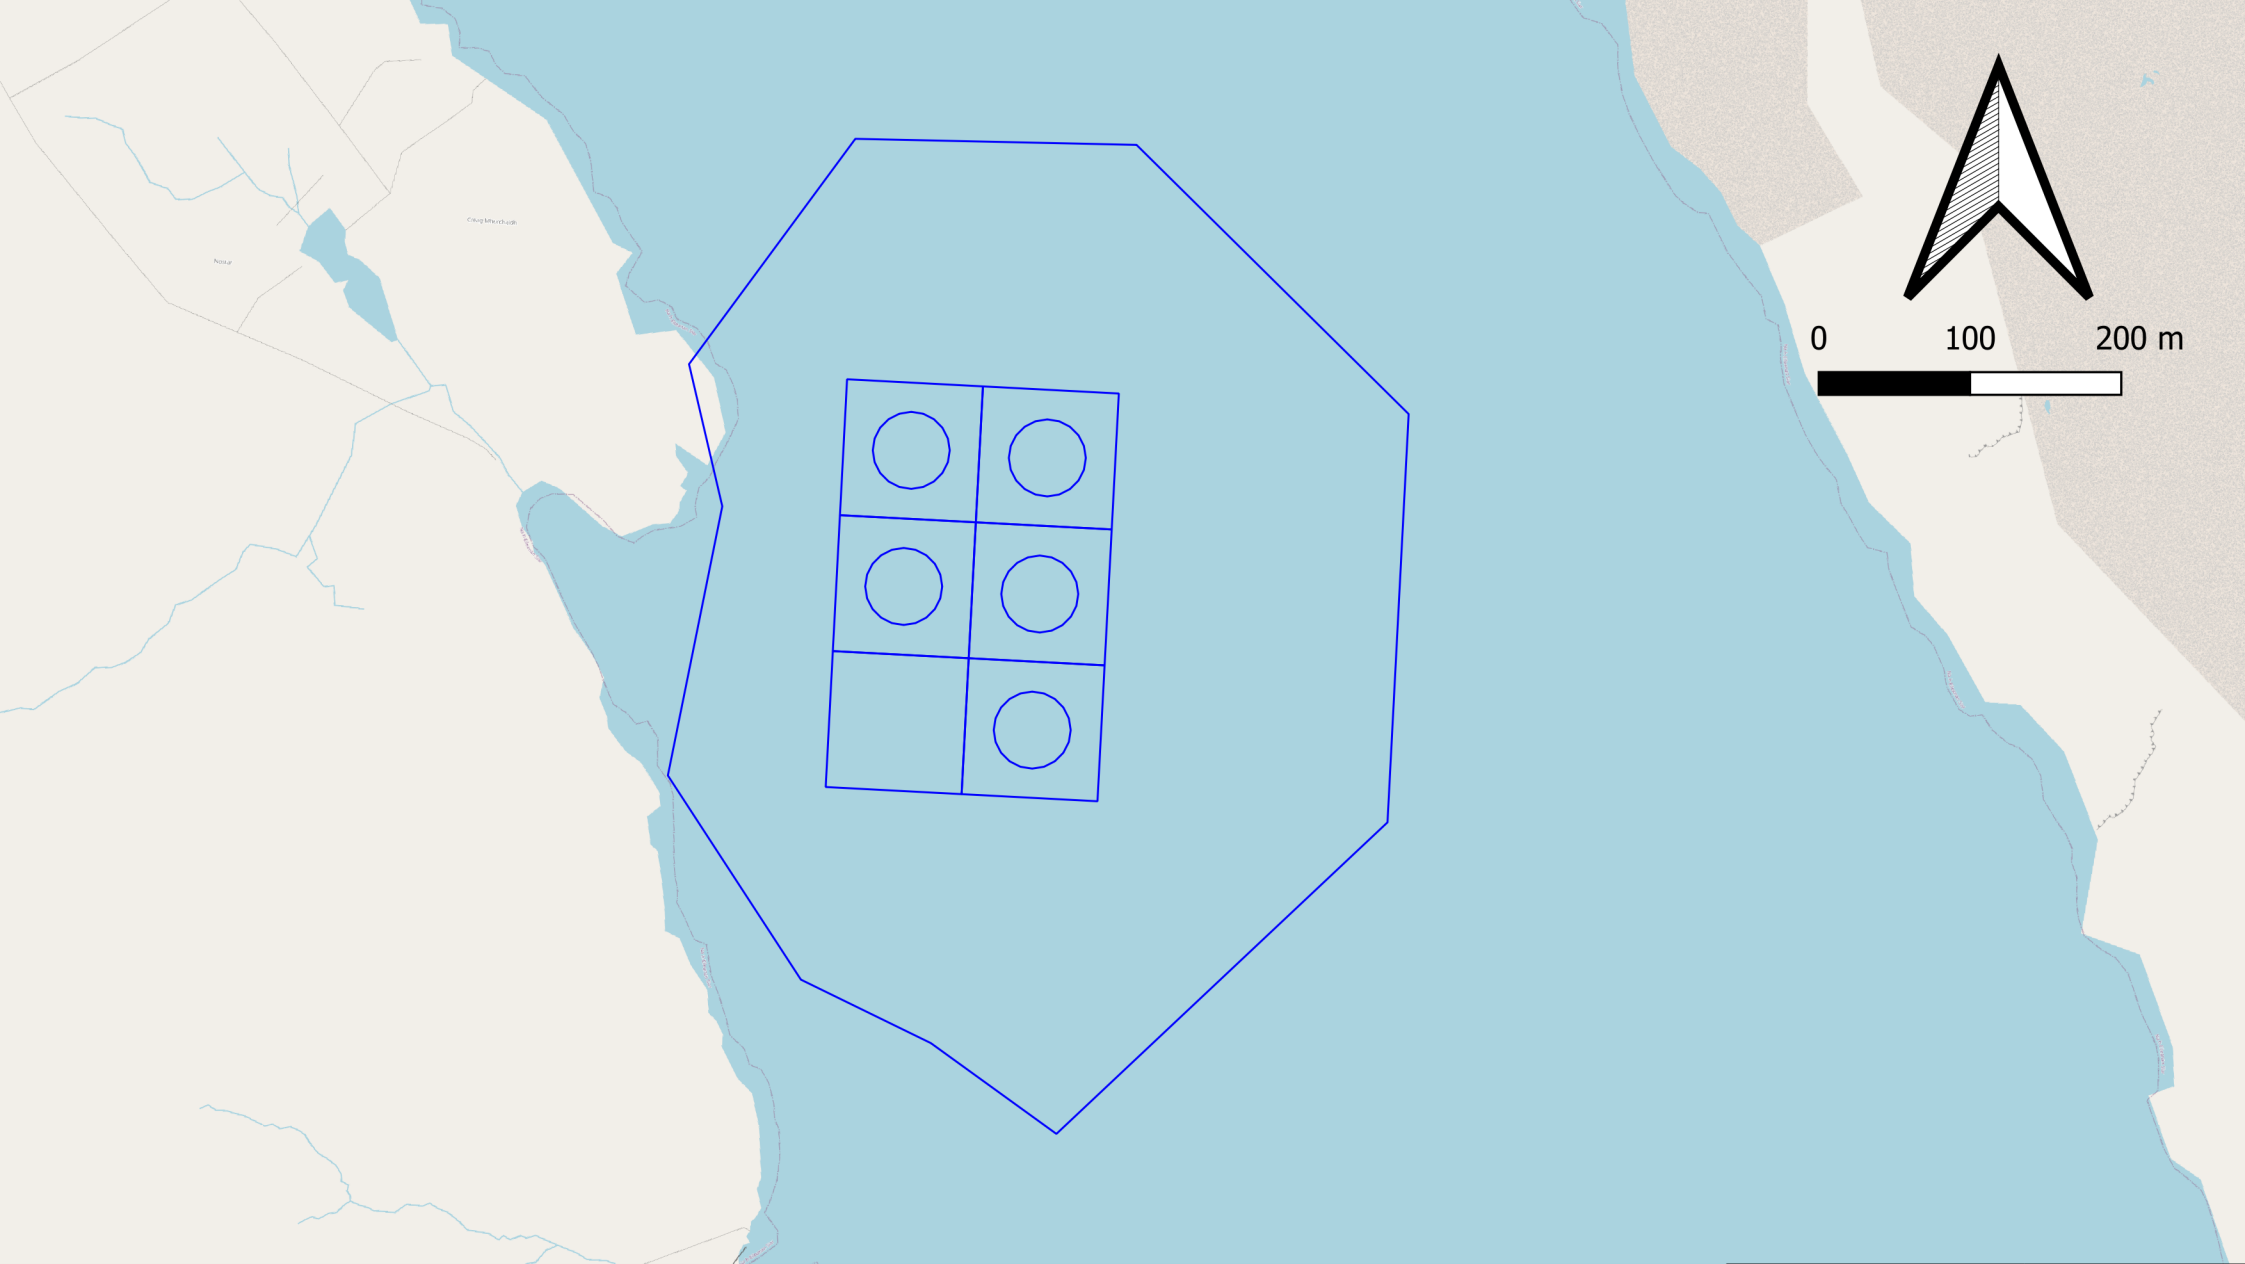

|                    |                                                                                                                                                                    |        |            |       |
|--------------------|--------------------------------------------------------------------------------------------------------------------------------------------------------------------|--------|------------|-------|
| SEAFORTH FISH FARM | <b>Legend</b><br><div><div></div> Existing 160m pens</div> <div><div></div> Proposed 160m pen</div> <div><div></div> Existing and proposed planning boundary</div> | 1:5000 | 2025-06-03 | SH    |
| Site Plan          |                                                                                                                                                                    | Scale  | Date       | Drawn |

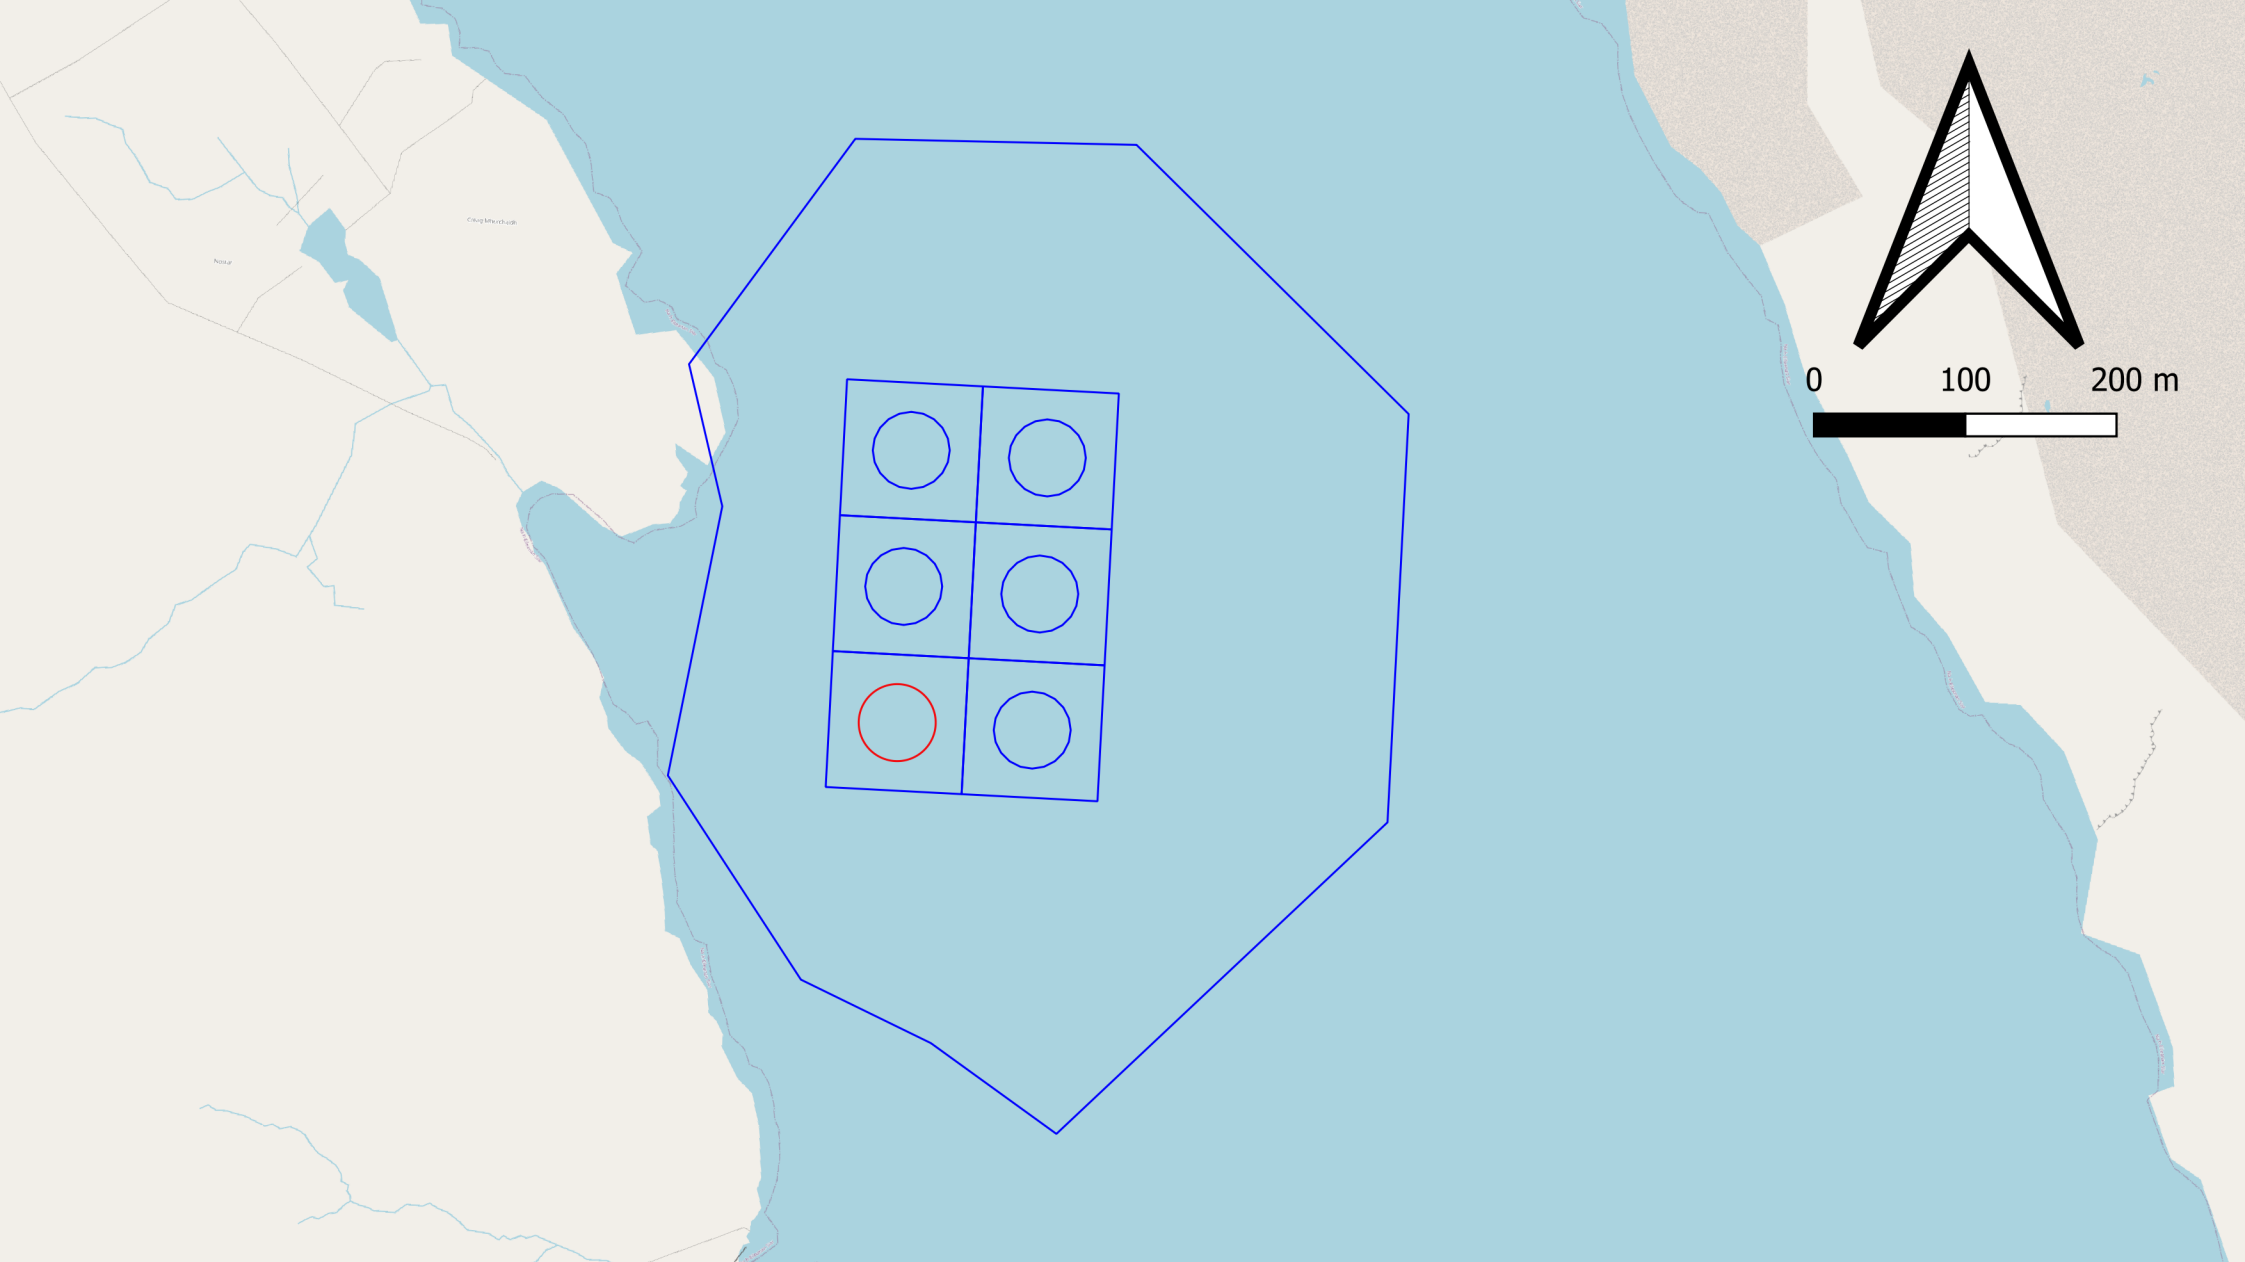

|                                       |                                                                                                                                                                    |        |            |       |
|---------------------------------------|--------------------------------------------------------------------------------------------------------------------------------------------------------------------|--------|------------|-------|
| SEAFORTH FISH FARM                    | <b>Legend</b><br><div><div></div> Existing 160m Pens</div> <div><div></div> Proposed 160m Pen</div> <div><div></div> Existing and proposed planning boundary</div> | 1:5000 | 2025-06-03 | SH    |
| Supplementary 1:10,000 admiralty plan |                                                                                                                                                                    | Scale  | Date       | Drawn |



|                              |                                   |          |            |       |
|------------------------------|-----------------------------------|----------|------------|-------|
| SEAFORTH FISH FARM           | Proposed at Seaforth shown in red | 1:25,000 | 2025-06-03 | SH    |
| Supplementary admiralty plan |                                   | Scale    | Date       | Drawn |

## Seaforth Coordinates

### Existing

#### Planning Boundary

|          |          |
|----------|----------|
| E 123075 | N 903289 |
| E 123261 | N 903285 |
| E 123441 | N 903107 |
| E 123427 | N 902837 |
| E 123208 | N 902631 |
| E 123125 | N 902691 |
| E 123039 | N 902733 |
| E 122951 | N 902868 |
| E 122987 | N 903046 |
| E 122965 | N 903140 |
| E 123075 | N 903289 |

#### Grid Corners

|          |          |
|----------|----------|
| E 123070 | N 903130 |
| E 123249 | N 903121 |
| E 123235 | N 902851 |
| E 123055 | N 902860 |

#### Pen Centres

|          |          |
|----------|----------|
| E 123112 | N 903083 |
| E 123202 | N 903078 |
| E 123107 | N 902993 |
| E 123197 | N 902988 |
| E 123192 | N 902898 |

### Proposed

Planning Boundary – No Change

Grid Corners – No Change

#### Pen Centres

|          |          |
|----------|----------|
| E 123112 | N 903083 |
| E 123202 | N 903078 |
| E 123107 | N 902993 |
| E 123197 | N 902988 |
| E 123192 | N 902898 |
| E 123103 | N 902903 |