


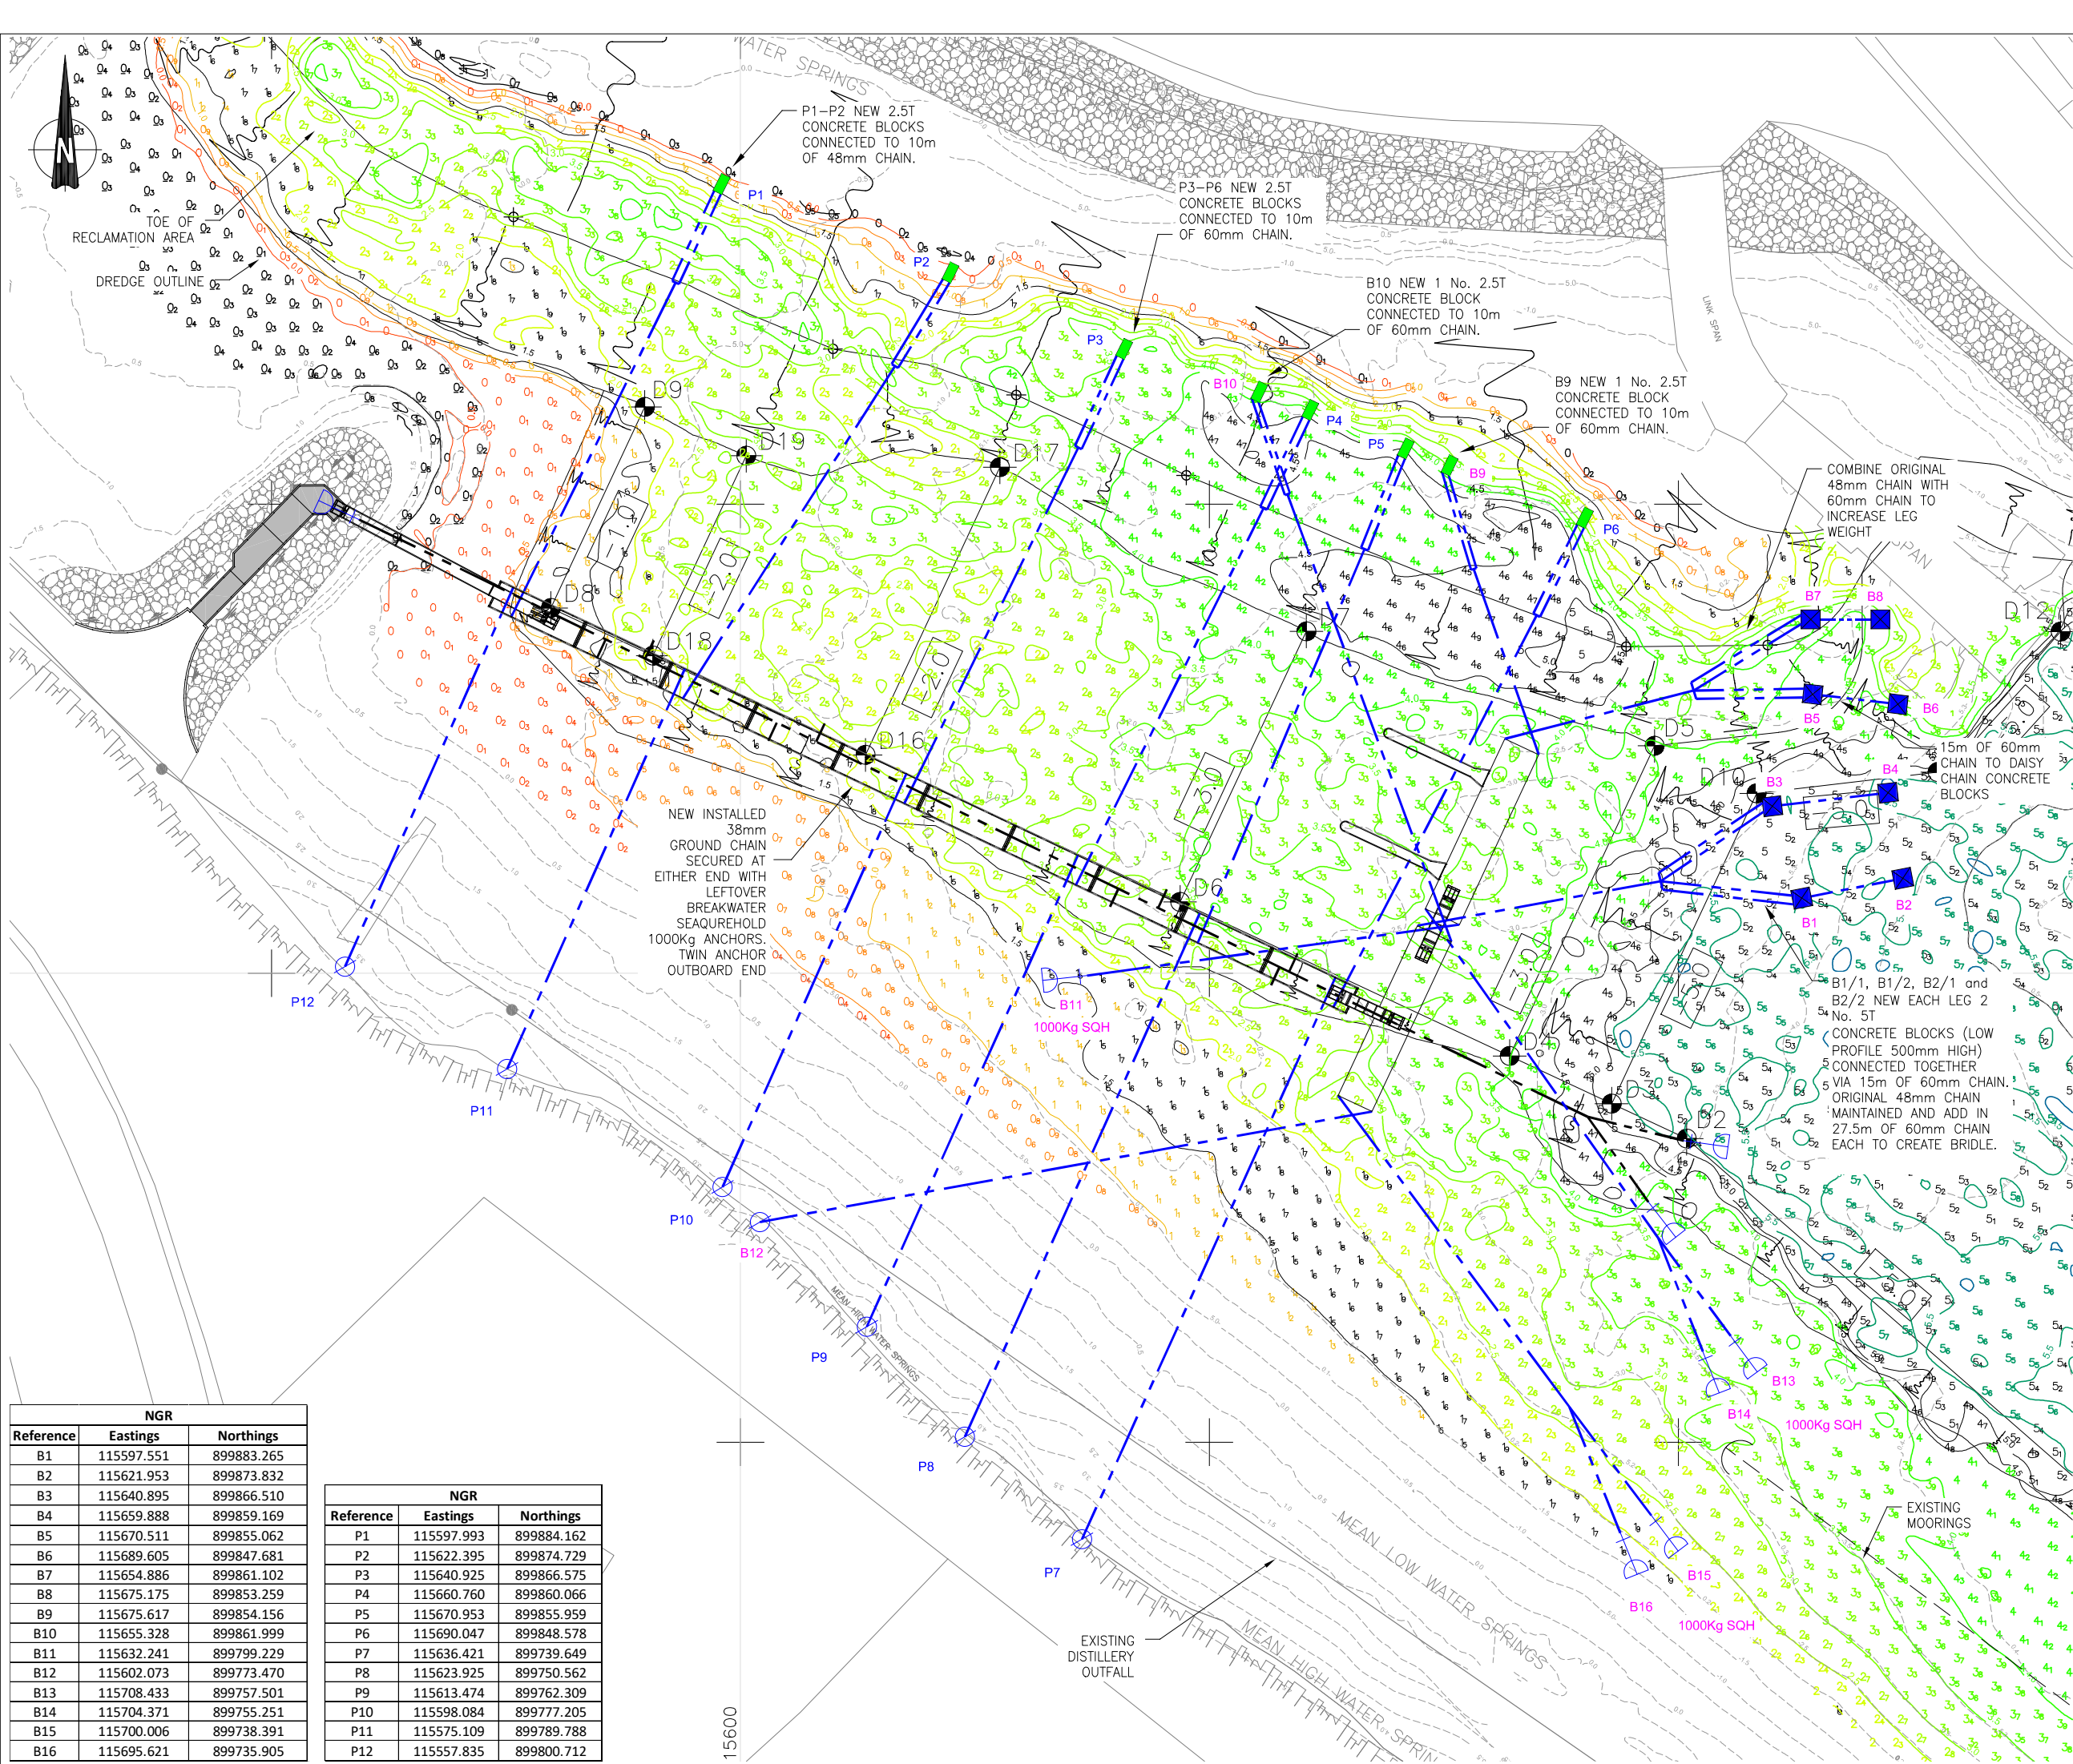

REV.	DATE	DESCRIPTION	BY	CHK'D	DATE
A1	12.06.19	FIRST ISSUE	K.W.	S.M.	12.06.19
A2	10.07.19	CONCRETE BLOCKS ADDED	K.W.	J.L.	10.07.19
C1	21.10.19	FOR CONSTRUCTION	K.W.	J.L.	21.10.19
C2	06.08.20	ALTERATION AFTER ANCHOR TEST	J.L.	S.M.	06.08.20
C3	12.08.20	ANNOTATIONS AMENDED	K.W.	S.M.	12.08.20
C4	13.08.20	ANCHOR COORDINATES UPDATED	K.W.	S.M.	13.08.20
Z1	26.11.20	AS BUILT	K.W.	S.M.	26.11.20

GENERAL NOTES (Unless Noted Otherwise)

1. ALL DIMENSIONS IN MILLIMETERS
2. IF IN DOUBT ASK

LEGEND

ANCHORS & ROCK PINS

5T CONCRETE ANCHOR BLOCKS

2.5T CONCRETE ANCHOR BLOCKS

MOORING LINE

NOTE:
MOORINGS DESIGNED TO BS 6349

 **GaelForce**
ENGINEERING

136 ANDERSON STREET,
INVERNESS, IV3 8DH
T. 01463 229400

www.gaelforcegroup.com

NGR		
Reference	Eastings	Northings
B1	115597.551	899883.265
B2	115621.953	899873.832
B3	115640.895	899866.510
B4	115659.888	899859.169
B5	115670.511	899855.062
B6	115689.605	899847.681
B7	115654.886	899861.102
B8	115675.175	899853.259
B9	115675.617	899854.156
B10	115655.328	899861.999
B11	115632.241	899799.229
B12	115602.073	899773.470
B13	115708.433	899757.501
B14	115704.371	899755.251
B15	115700.006	899738.391
B16	115695.621	899735.905

NGR		
Reference	Eastings	Northings
P1	115597.993	899884.162
P2	115622.395	899874.729
P3	115640.925	899866.575
P4	115660.760	899860.066
P5	115670.953	899855.959
P6	115690.047	899848.578
P7	115636.421	899739.649
P8	115623.925	899750.562
P9	115613.474	899762.309
P10	115598.084	899777.205
P11	115575.109	899789.788
P12	115557.835	899800.712

DRAWING TITLE: TARBERT REINSTATED MOORING LAYOUT		CLIENT: —
DRAWN BY: K. WATSON	DATE: 12.08.2020	CONTRACT DESCRIPTION: PONTOONS
CHECKED: S. MILNE	DATE: 12.08.2020	CONTRACT DWG. No: M-11029-003
SCALE: N.T.S.		STANDARD DWG. REF: —
		REVISION: —