

REV.	DATE	DESCRIPTION	BY	CHK'D	DATE
A1	22.06.21	FIRST ISSUE	K.W.	S.M.	22.06.21
Z1	31.10.22	AS-BUILT	K.W.	S.O.	31.10.22




PAINT / FINISH SPECIFICATION

-

GENERAL NOTES *(Unless Noted Otherwise)*

1. ALL DIMENSIONS IN MILLIMETRES (mm)
2. IF IN DOUBT ASK

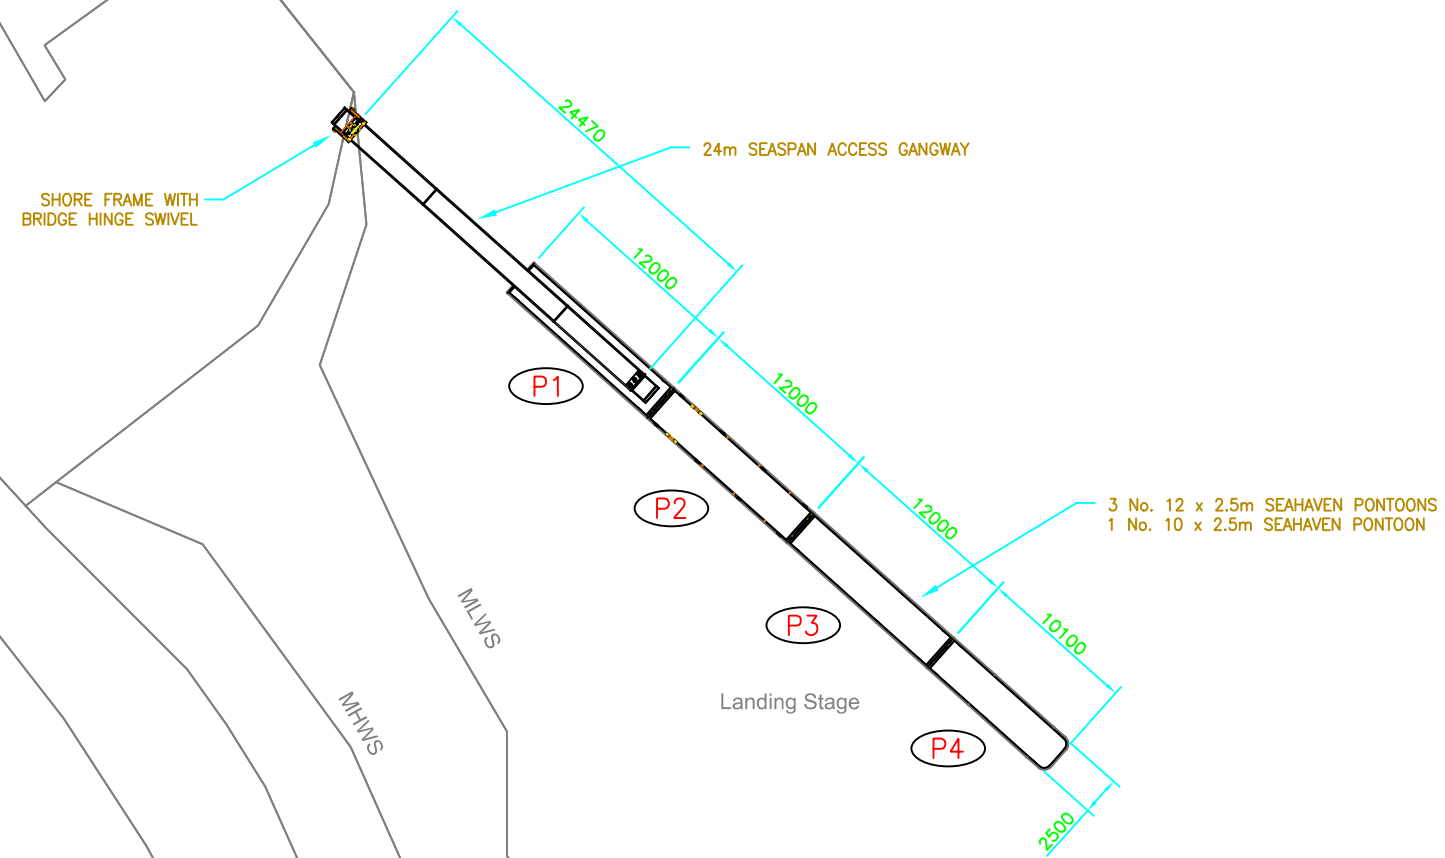

PONTOON SITE PLAN - AS-BUILT

GaelForce ENGINEERING
 136 ANDERSON STREET,
 INVERNESS, IV3 8DH
 T. 01463 229400
 www.gaelforcegroup.com

DRAWING TITLE: CUDDY POINT PONTOON SITE PLAN - AS-BUILT		CLIENT: -
DRAWN BY: K. WATSON	DATE: 22.06.2021	CONTRACT DESCRIPTION: PONTOONS
CHECKED: S. MILNE	DATE: 22.06.2021	CONTRACT DWG. No: E-5795-005
SCALE: N.T.S.	REVISION: Z1	STANDARD DWG. REF: -

PRODUCED ON AUTOCAD BY GAELFORCE ENGINEERING