


Legend

- Beatrice Offshore Wind Farm Site
- X As Laid Wave Rider Buoy
- X Planned Wave Rider Buoy Location
- ▲ Cardinal Buoy
- Special Marker
- Beatrice Site Entry Gates
- X Turbine
- OTM
- Spare
- Inter Array Cable

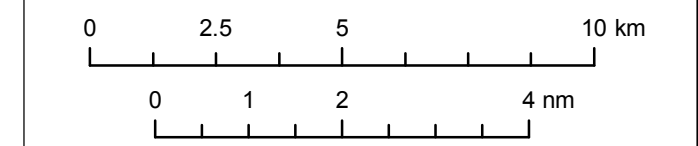

Data Source:
 © British Crown and SeaZone Solutions Limited. All rights reserved. Products licence No. 112009.005.

Drawing Title

Buoy and Marker Locations

| Ver | Date | Remarks | Drawn | Checked |
|-----|------------|------------------------------------|-------|---------|
| 01 | 14/09/2017 | First issue | MM | LR |
| 02 | 20/09/2017 | Planned wave rider locations added | MM | LR |
| | | | | |

Drawing Number

BEA-MAP-SSER-746

| | | | |
|-----------|-----------|-------|------------|
| Scale | Plot Size | Datum | Projection |
| 1:150,000 | A3 | WGS84 | UTM30N |

SSE Renewables (UK) Ltd. 2017. The concepts and information contained in this document are the copyright of SSE Renewables (UK) Ltd. Use or copying of the document in whole or in part without the written permission of SSE Renewables (UK) Ltd constitutes an infringement of copyright. SSE Renewables (UK) Ltd does not warrant that this document is definitive nor free of error and does not accept liability for any loss caused or arising from reliance upon information provided herein.

Beatrice
Offshore Windfarm Ltd